

20.07.2004

STAV. PLĀNS. LĪCĪGĀ 7401-003-0319-004

Ogres
Mākalnes prosp. 38




20.07.2000

7401-003-0319-004

Ogres
Mārkaines prosp. — 38

2. Stāvs
h = 2.50

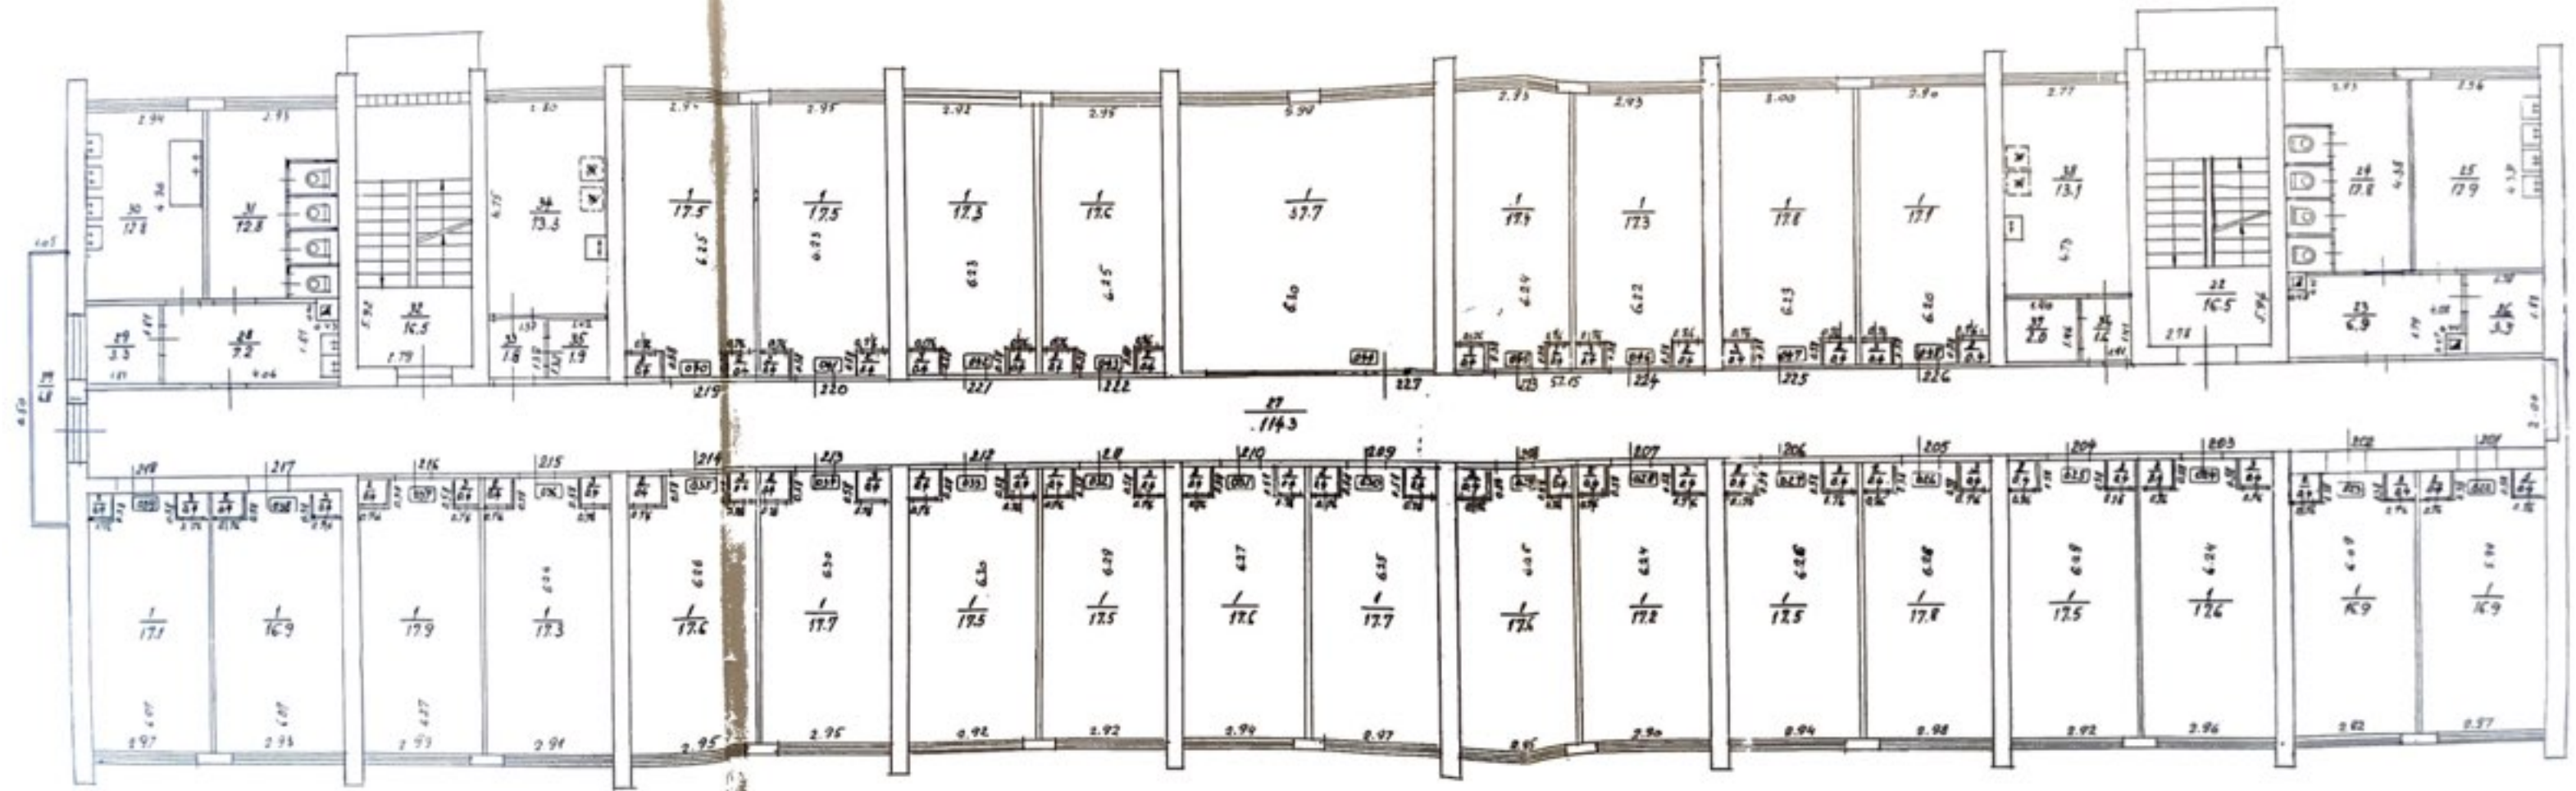


2000. 20.07.2000

20.07.2000

STANDARD FORM NO. 64-7701-003-0319-004

apreço: Ogres planta: ~~mapas~~
~~planta~~: Málkalnes prosp. número: 38

3. Stave
\$1.50

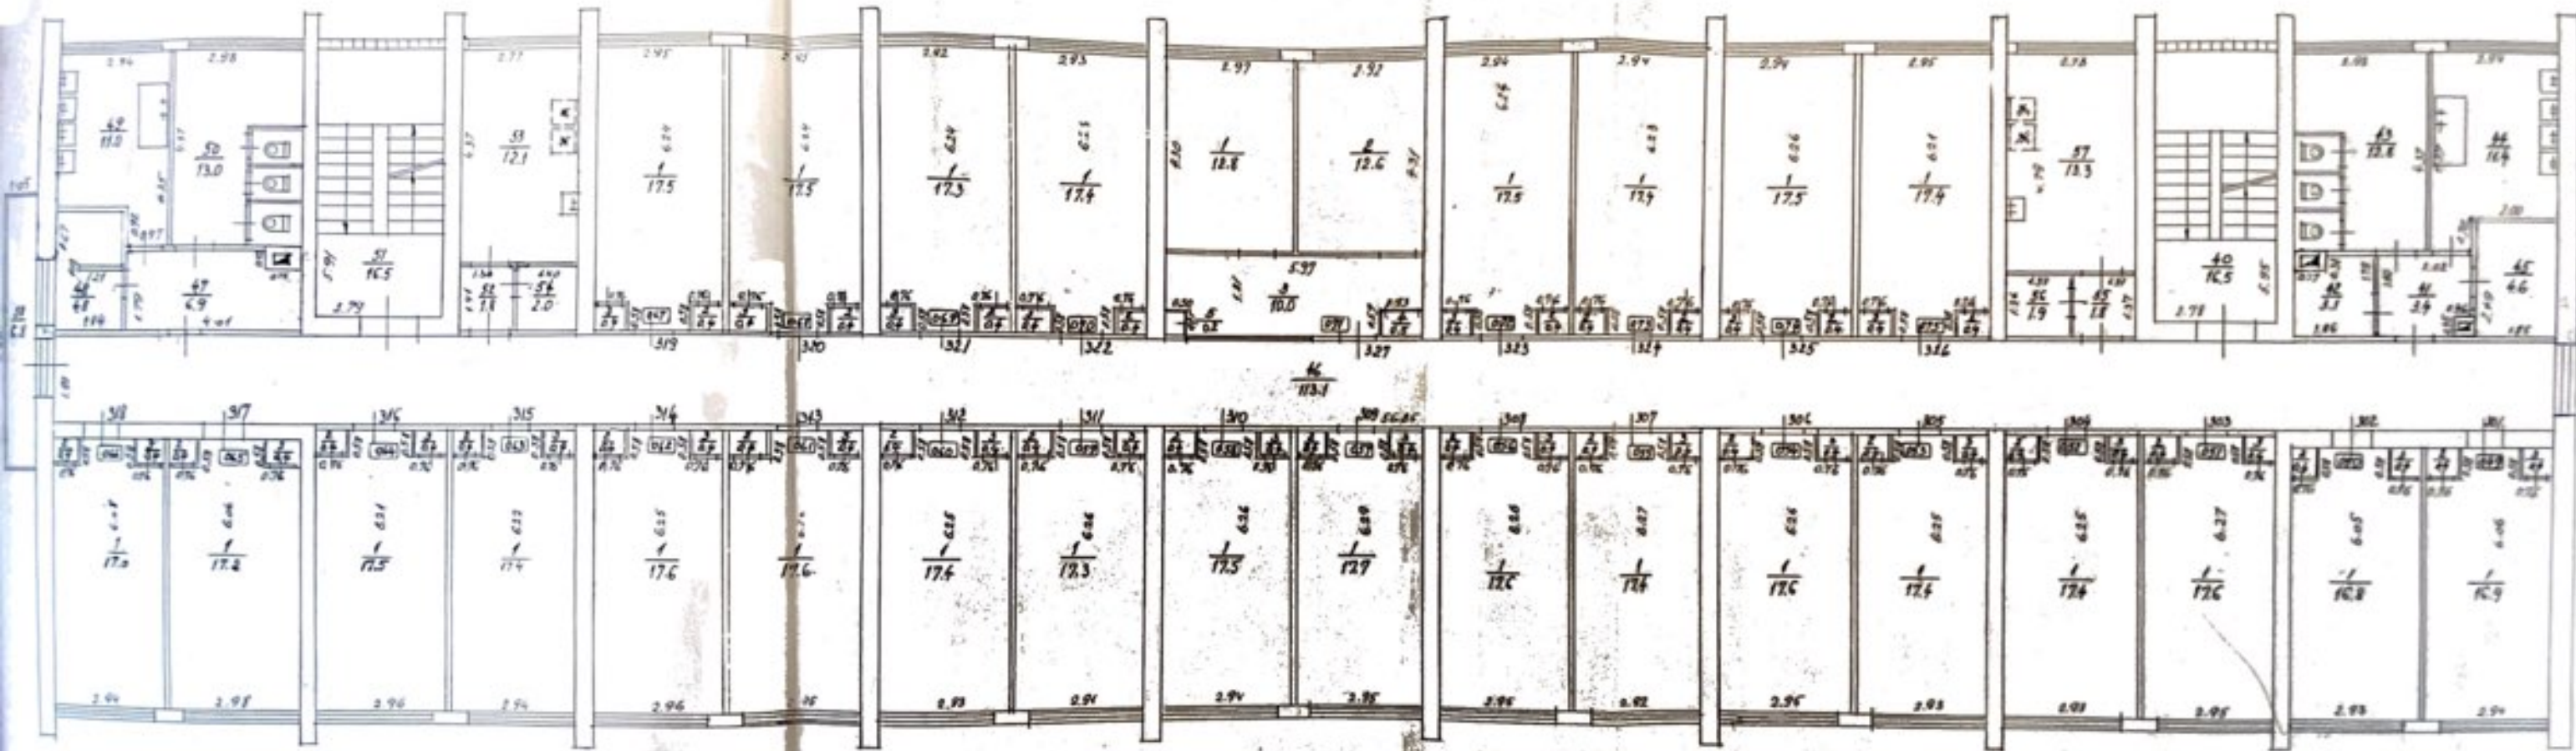

Scale: 1:100

2000 - 2001


10.07.2000-9.

STAIN : 244

7401-003-0349-004

Agres
Mălkaines prosp. → nr. 38

4. 2.50

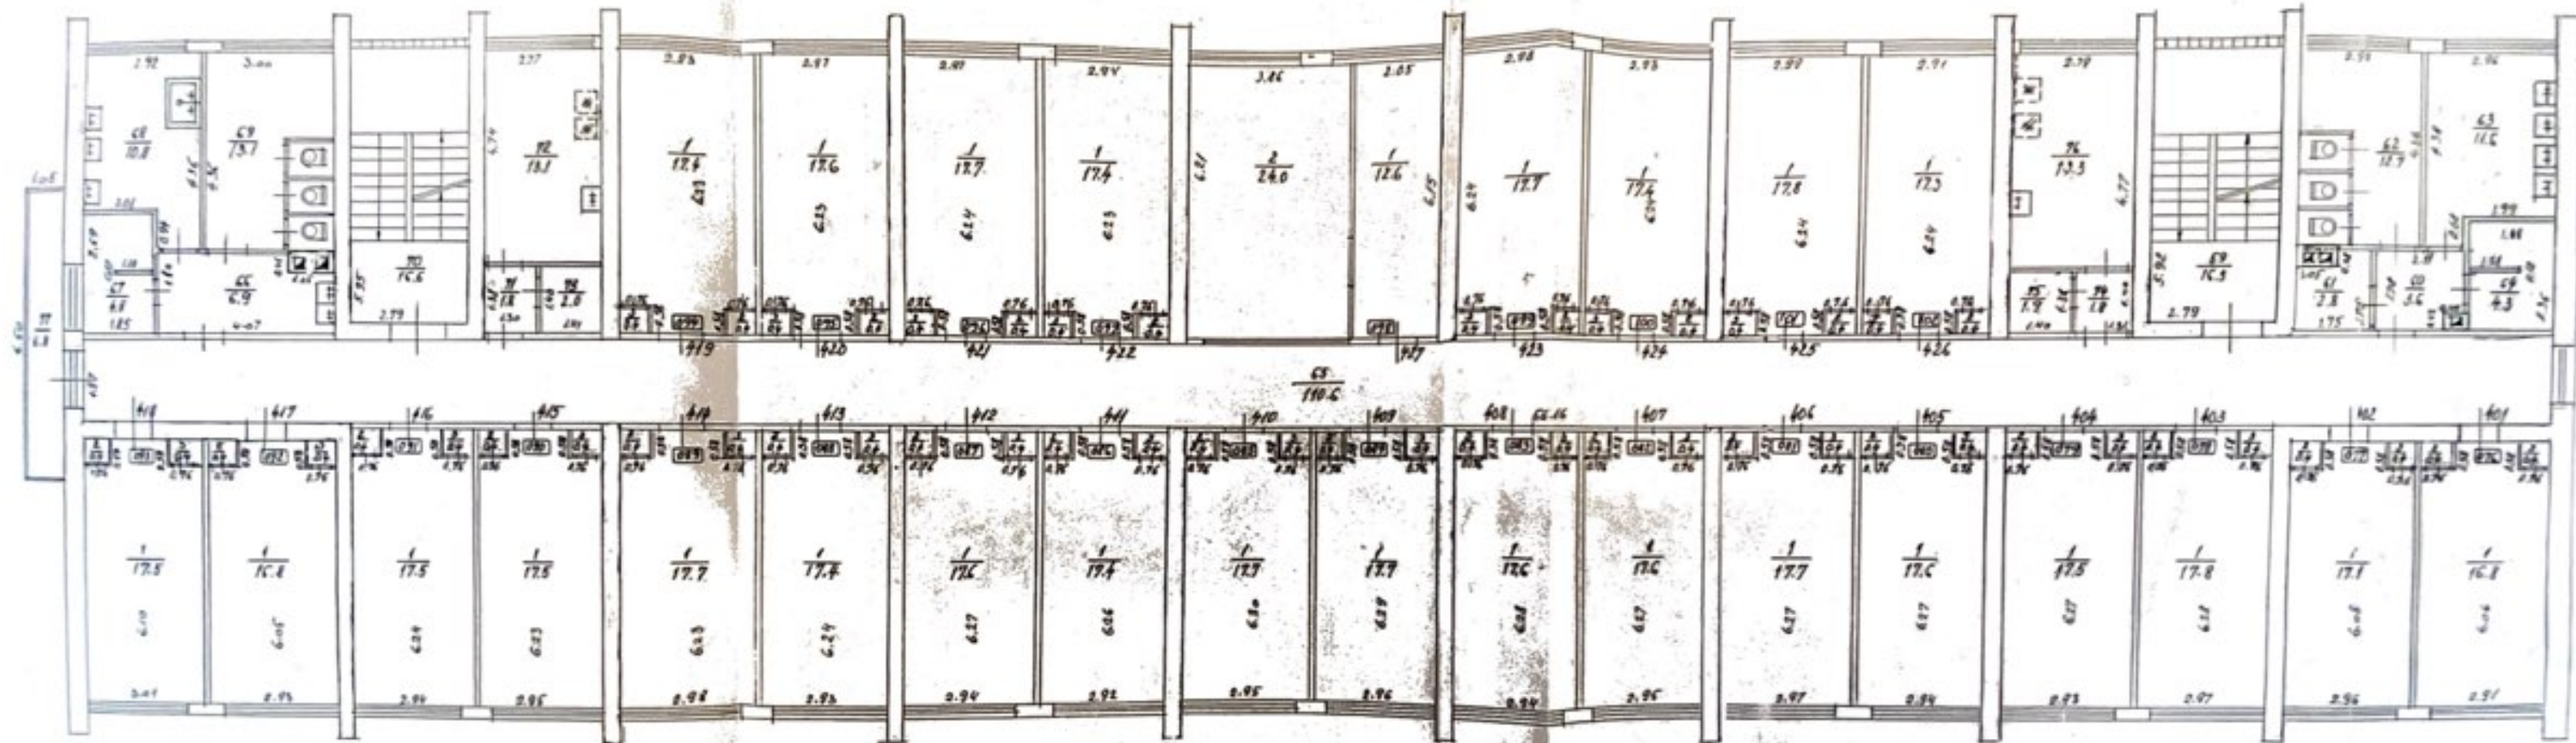

MS-emp 1:100


1000. 2.0. 1971

20.07.2000 g.

STĀVA PLĀNS CĒLTĀJĀ. 740/-003-0379-004

Agres ~~plata, 1000~~

Mälkalnes prosp. → 38
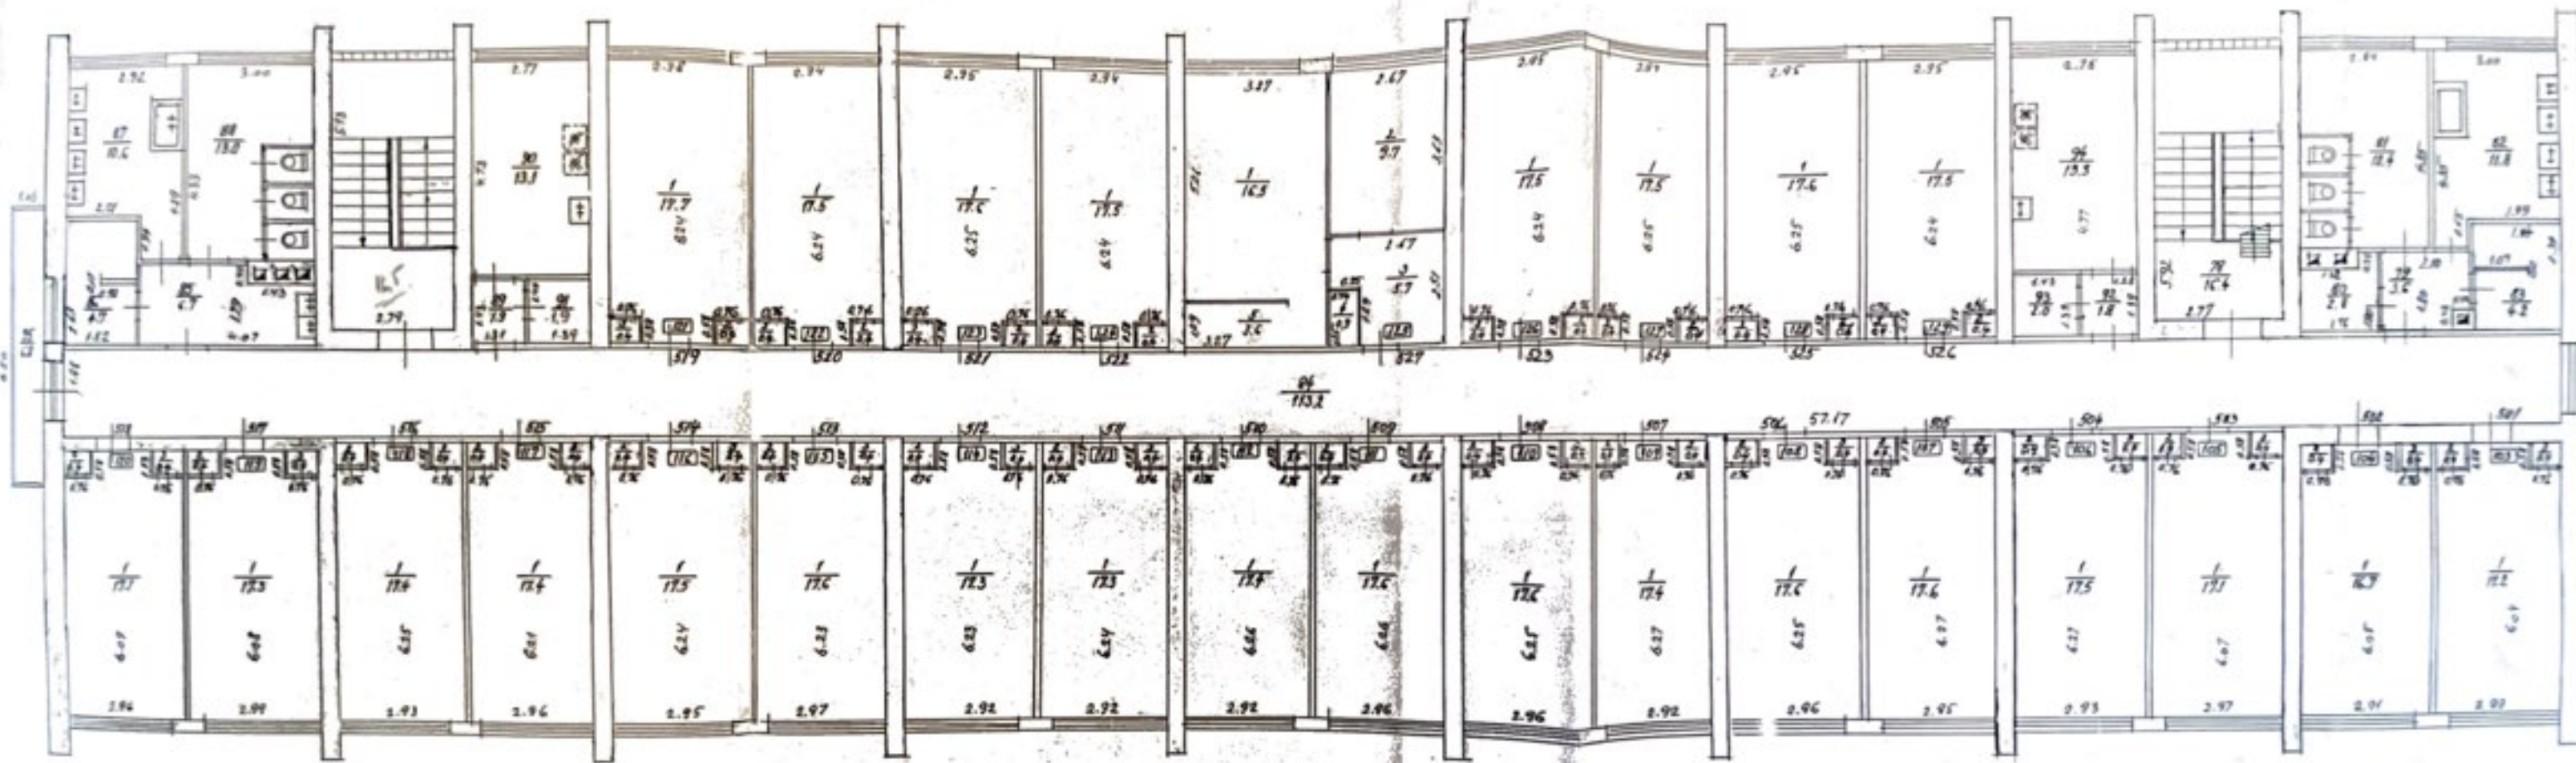
$$f_2 = 2.50$$


Page 100

2000 2001