
CONCRETE:	*B30(M400)W8 (Watertight; sulphate resisting portland cement)*
REINFORCEMENT (T):	*AIII (A400H)*
PROTECTIVE CONCRETE LAYER:	*50mm*

20-20

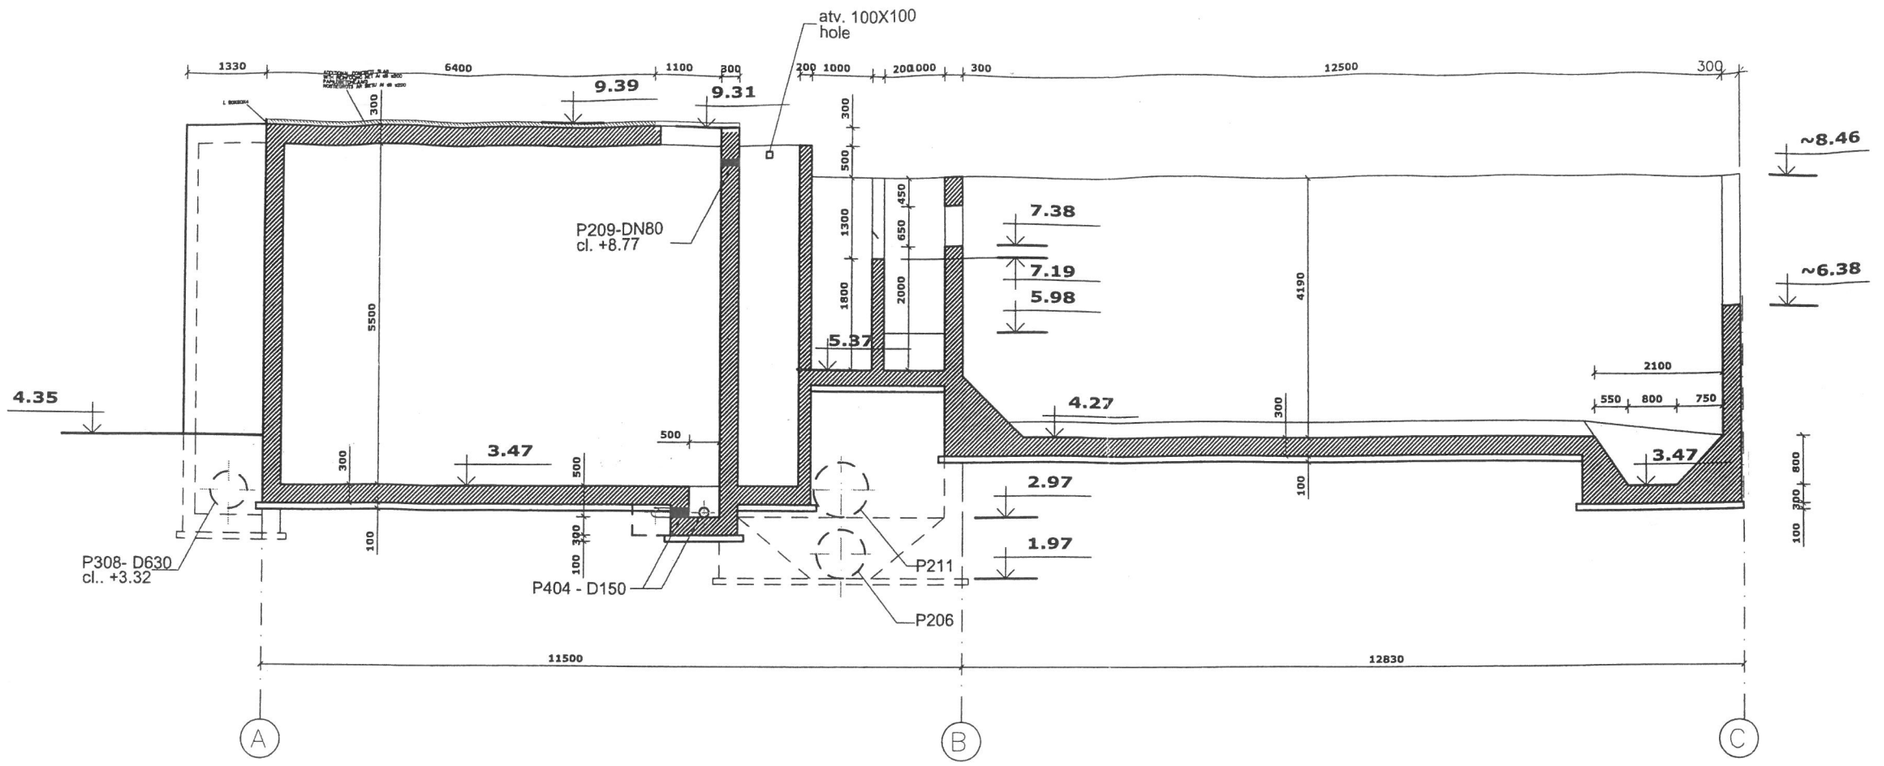

AS Built Drawing/ Izpildrasējums

Part	Description	Dimensions	Material	Pcs	Notes

SLOKA WWTP, JURMALA UDENS

PRETREATMENT AND SLUDGE TREATMENT BUILDING:
SECTION 20–20.

Designed	Drawn	Checked	Approved	Date

Scale 1:100

Work No.	Drawing No.	Revision	Arch. No.
TO4 110	028–C–311		

YIT Construction Ltd
Water and Enviromental Service

Address: Box 36 (Panuntie 6) 00621 HELSINKI, FINLAND
Tel.Inti: +358-20 43 31 11
Telefax: +358-20 43 32 06 6
E-mail: first name.surname@yit.fi

Izpild.	I.Vojevodins		07.2008		
	J.Krūmiņš				

PASŪTĪTĀJS: YIT CONSTRUCTION LTD

LĪG. NR.: 1001/ENV/12029

OBJEKTS: KANALIZĀCIJAS NOTEKŪDEŅU ATTĪRĪŠANAS IETAISES SLOKĀ, MEŽMALAS IELĀ 41

PROJ. DAĻA: BŪVKONSTRUKCIJAS

STADIJA	LAPAS Nr.
Izpilde	DZK1–10

LAPA: PRIEKŠAPSTRĀDES UN DŪŅU APSTRĀDES ĒKA GRIEZUMS 20-20

" A PROJECTS " SIA
PILSU IELA 6, 404. KAB.
LIEPĀJA
T. 9481482, 34 22885